REVISIONS			
ISS#	REV#	APPVD	DATE
AS BUILT DOCUMENT			
1	B	LD	2-05-2010
UPDATED PER NA110111-85327			
2	A	LD	10-8-2012

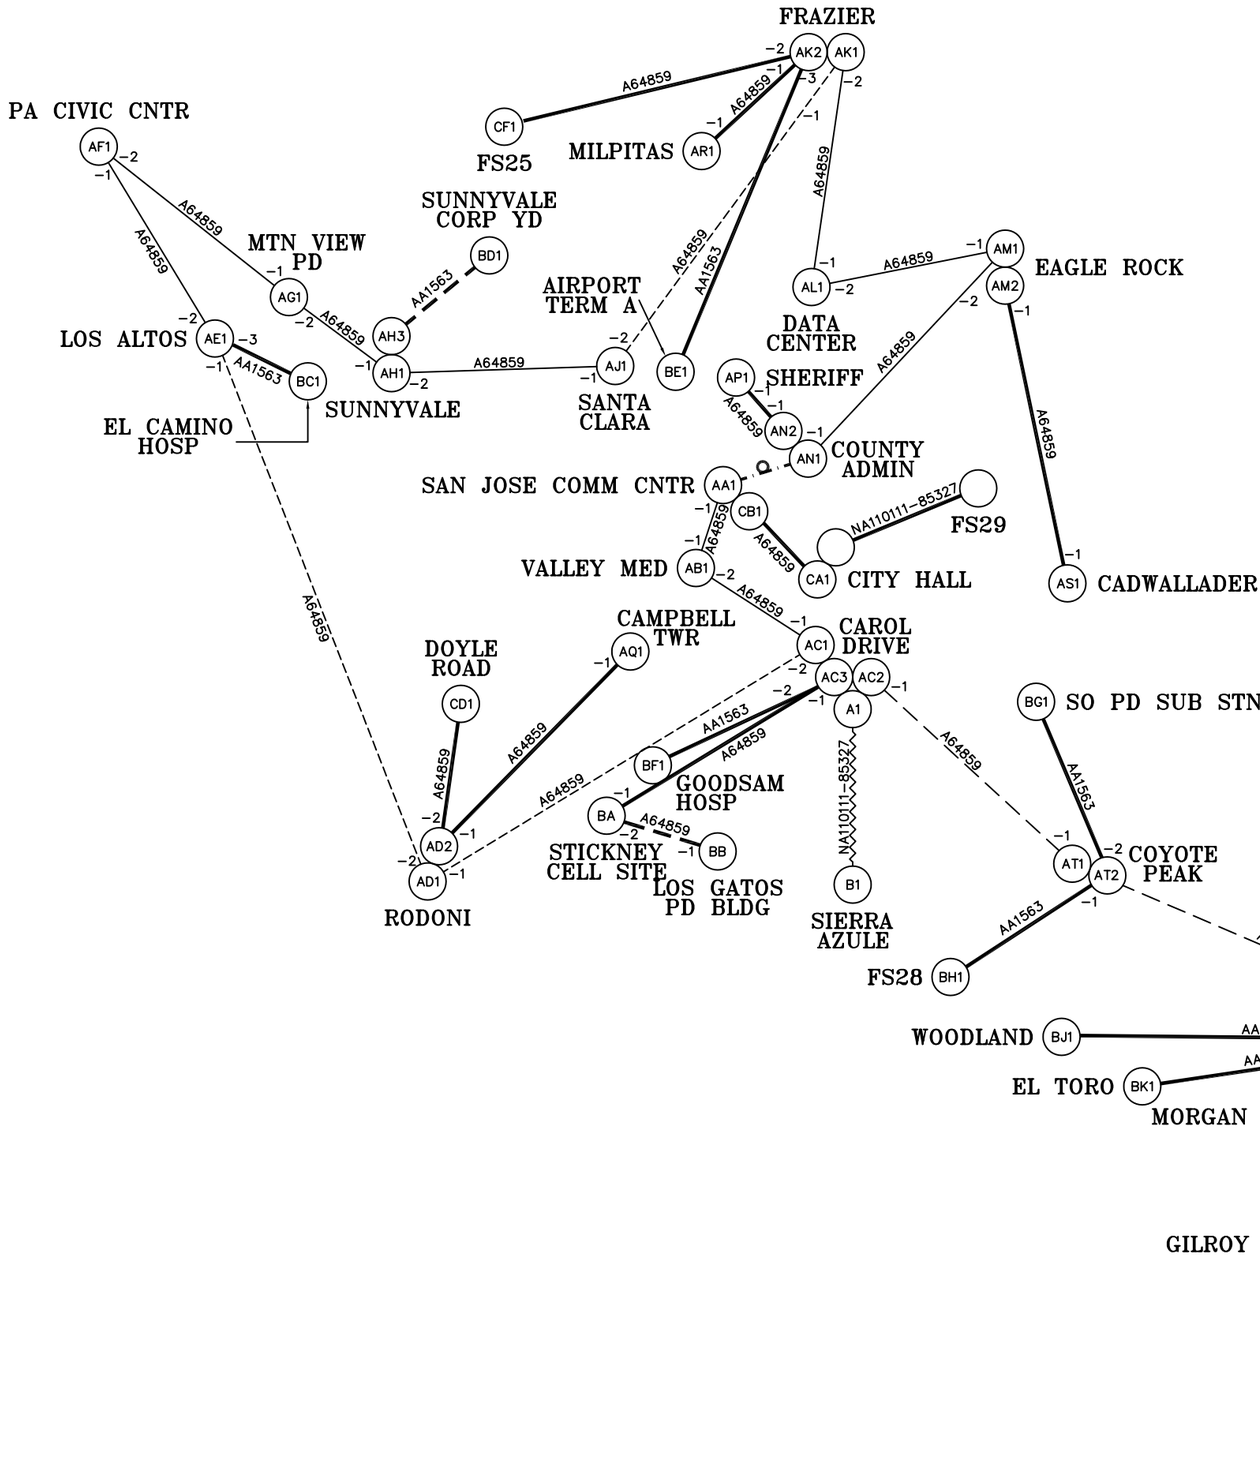

LEGEND:

- = TRUEPOINT 5211 100T1, MHSB
- = TRUEPOINT 6411 OC3, MHSB
- = TRUEPOINT 6406 OC3, MHSB
- = TRUEPOINT 5211 29T1, MHSB
- = EXISTING FIBER
- = TRUEPOINT 5218 DS3+1T1, MHSB
- = CONSTELLATION 6 28T1, MHSB
- = ECLIPSE IRU600 16T1, MHSB

(X) INDICATES EL#.

-X INDICATES RADIO SIDE.

<X> INDICATES A PASSIVE REPEATER.

Aviat NETWORKS

AVIAT NETWORKS PROPRIETARY INFORMATION.

SL-AA1563-1

COUNTY OF SANTA CLARA

SYSTEM LAYOUT

ENGINEER: LD

DRAFTER: ENS

SIZE B | SCALE NTS | SHEET: 1 OF 1